


HYDRAULIC PROFILE  
HORIZ 1" = 30' VERT 1" = 5'

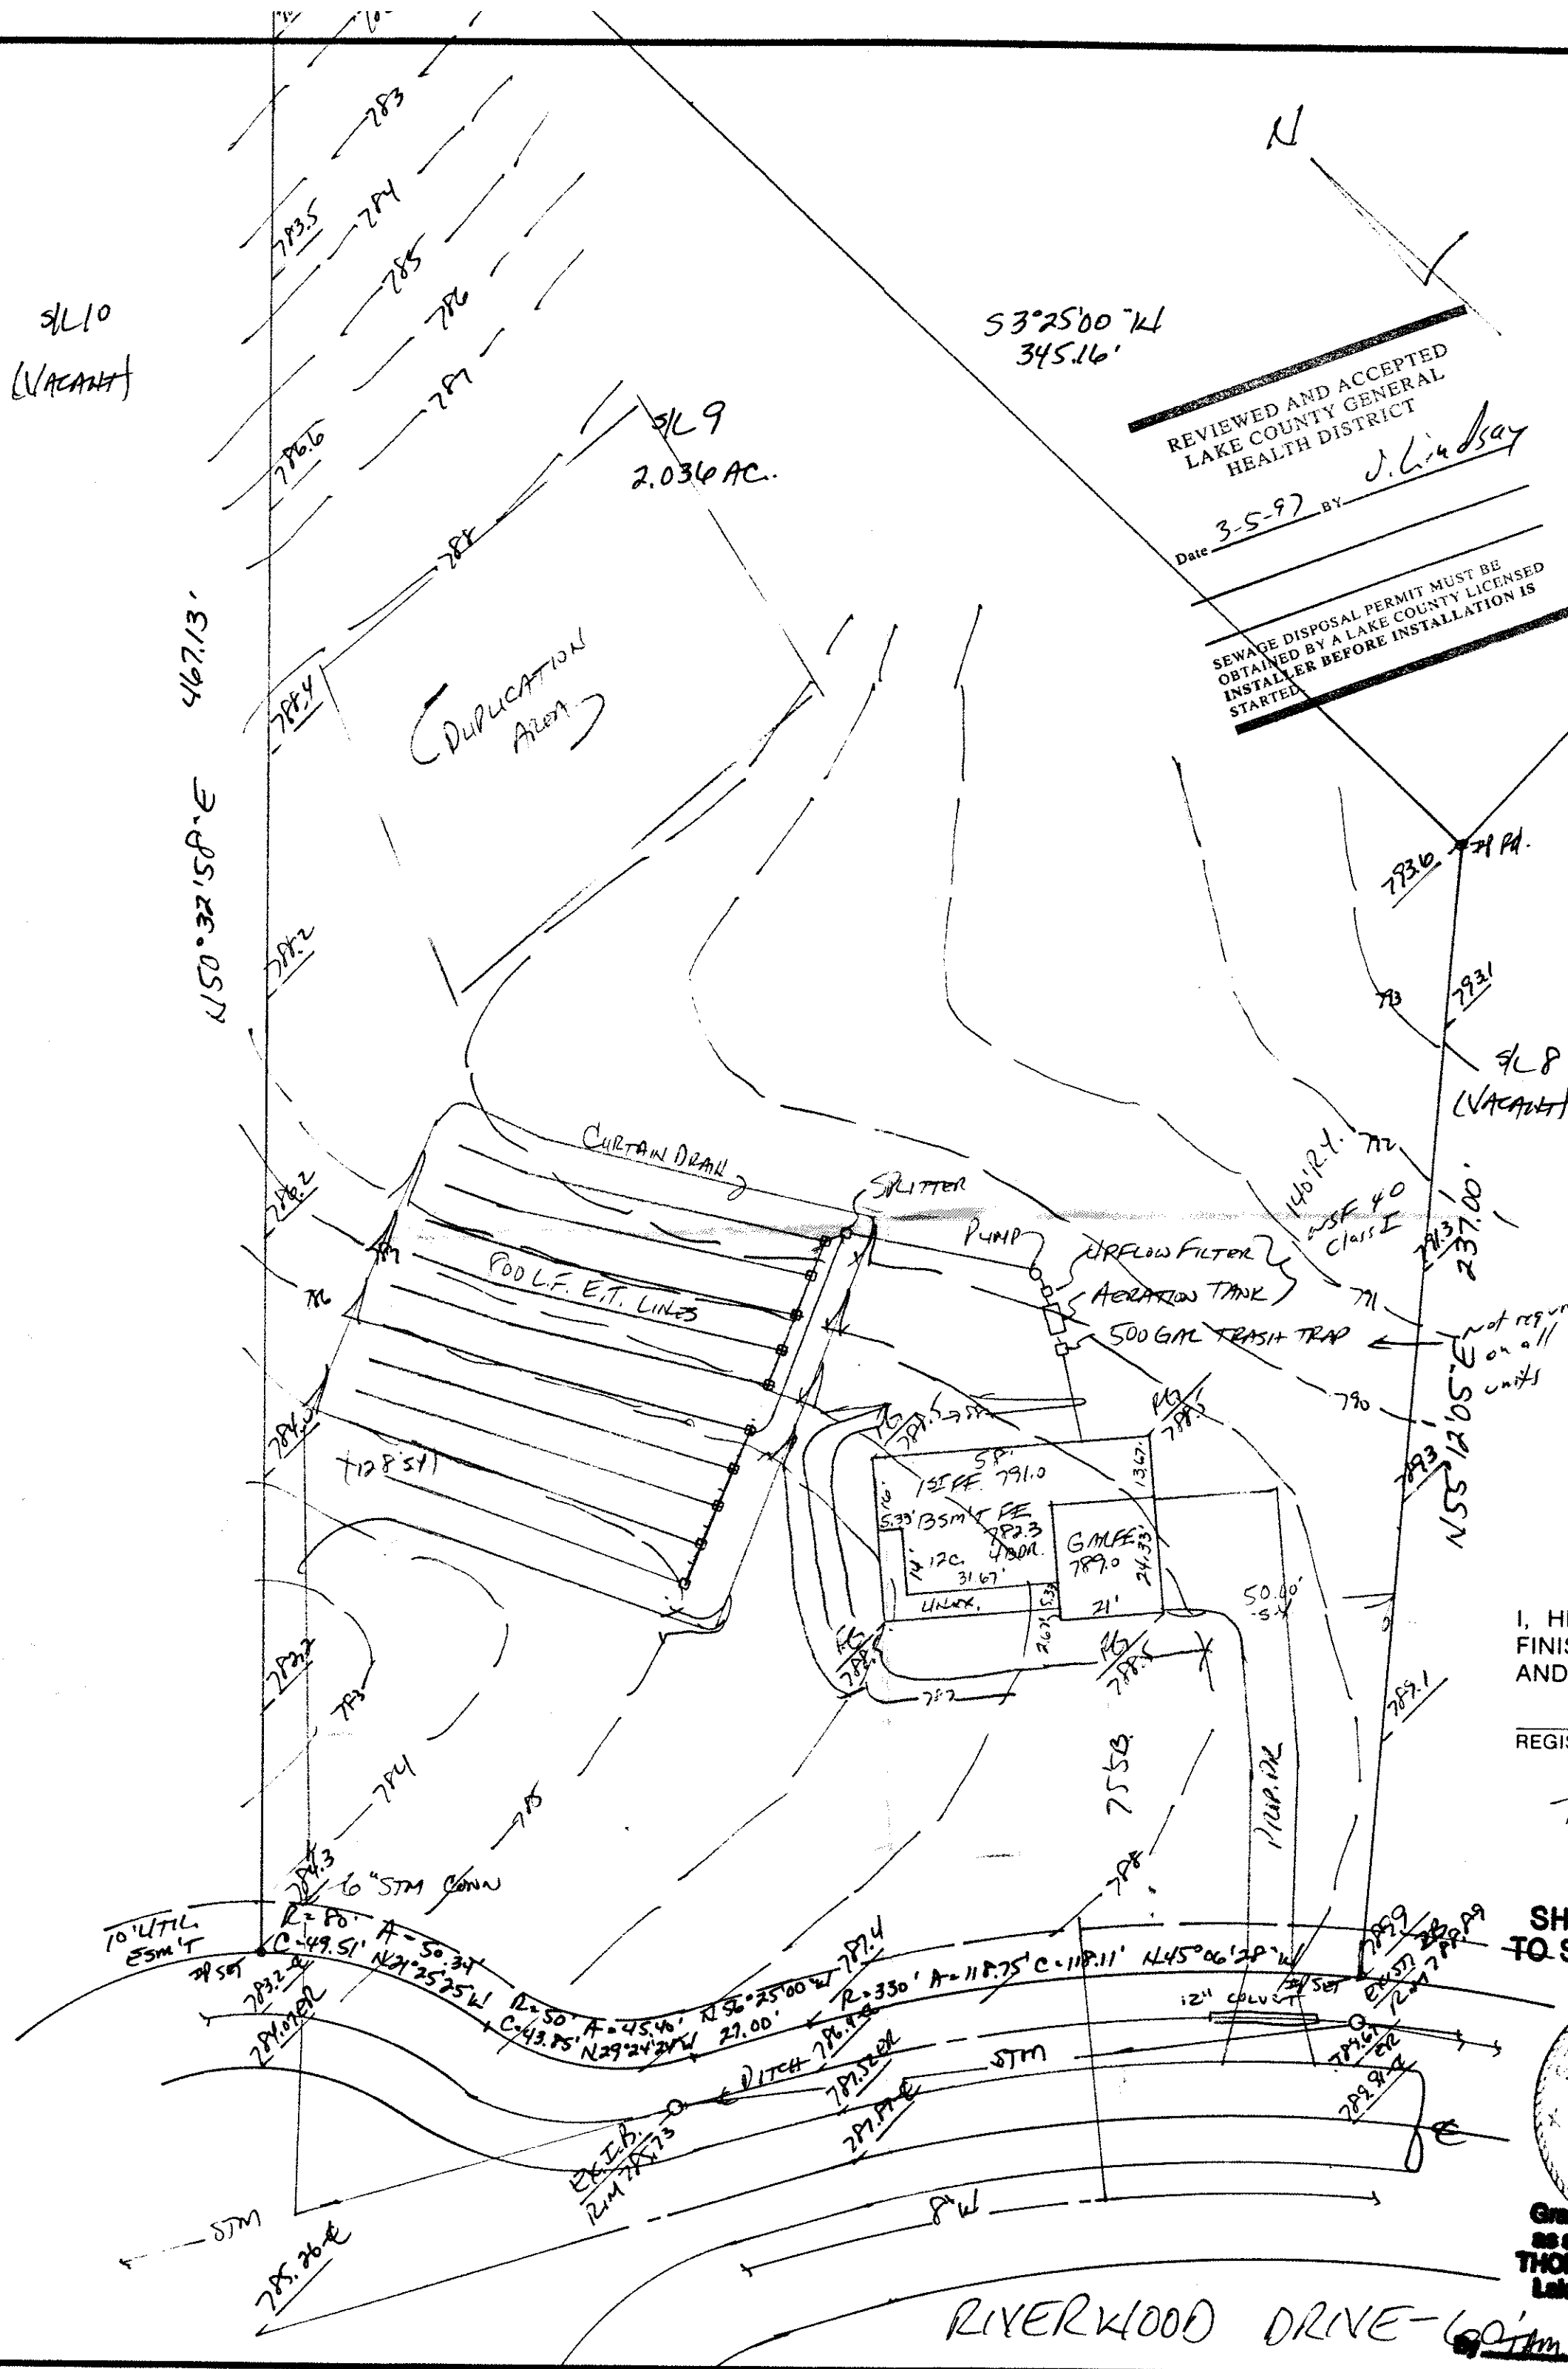

# SITE PLAN

PERRY TOWNSHIP, LAKE COUNTY, OHIO

for: PAULISIN BUILDERS  
CLIENT OWNER

ADDRESS STREET CITY ZIP

RIVERWOOD SUB.  
SUBDIVISION 27-28 NAME  
9 VOL. PG. RIVERWOOD DR  
SUBLOT NO. STREET

LOT TRACT  
VOLUME PAGE  
PERM. PARCEL NO. STREET

## LEGEND

- SANITARY MANHOLE
- STORM MANHOLE
- INLET OR CATCH BASIN
- HYDRANT
- EXISTING CONTOURS
- PROPOSED CONTOURS
- EXIST. ELEV.
- WATER VALVE (GAS)
- WATER METER (GAS)
- AS BUILT ELEVATION
- INDICATES DIRECTION OF SURFACE DRAINAGE

## REMARKS

ALL BOUNDARY DATA SHOWN WAS OBTAINED FROM (DEEDS, RECORDED SUBDIVISION PLAT OR OTHER PUBLIC RECORDS)  
LOCATIONS AS SHOWN OF ADJACENT WELLS AND SEPTIC TANKS OBTAINED FROM LAKE COUNTY HEALTH DEPARTMENT

## DESIGN CERTIFICATION

THIS PLAT WAS PREPARED BY ME, AND IS CORRECT TO THE BEST OF MY KNOWLEDGE AND BELIEF.

NAME SURVEYOR REGISTRATION NO.

## CHECK LIST

- NO. OF BEDROOMS
- DIMENSIONS
- BEARINGS
- TIE TO NEAREST STREET
- SUBLOT NO. PARCEL NO.
- SURROUNDING OWNERS
- BLDG. DIMENSIONS FIN. GR.
- BLDG. TIES FL'R. GRADES
- APRON TYPE WIDTH THICKNESS
- SIDEWALK TYPE WIDTH THICKNESS
- CULVERT TYPE DIA., LENGTH
- ROCK OUTCROPPINGS
- WATER MAIN SIZE, LOCATION
- SAN. SEWER SIZE % GR. LOC.
- SAN. MH. CAST. ELEV. INV. ELEV.
- SAN. CONN. SIZE, LOC. DEPTH
- STORM SEWER SIZE % GR. LOC.
- STORM MH. CAST. ELEV. INV. ELEV.
- PAV'T TYPE GRADE CURBS
- GAS LINE LOC. SIZE PRESSURE
- SEPTIC TANK LOCATION & DUPLICATION AREA
- WELL LOCATION
- ISOLATION RADIUS FROM WELL

## REVISIONS

NO.	DATE	BY
1		
2		
3		
4		
5		

## PLAN PREPARED BY:

BABCOCK • JONES & ASSOCIATES, INC.

PAINESVILLE, OHIO

DRAWN BY SCALE 1" = 30' PHONE NO. 357-1811  
CHK'D. DATE 1/20/97 DRAWING NO.  
CREW CHIEF APP'D. 96-272-9

## "AS BUILT" CERTIFICATION

I, HEREBY CERTIFY THAT THE CIRCLED GRADES ARE EXISTING FINISH GRADES CHECKED IN THE FIELD ON 1/20/97 AND ARE CORRECT TO THE BEST OF MY KNOWLEDGE AND BELIEF.


REGISTERED SURVEYOR

REG. NO.

TBM - NAIL IN TREE - S/L 9  
ELEV. ~ 787.88

ROOF DRAINS SHALL DISCHARGE TO SPLASH BLOCKS.

APPROVED  
SIDE LINES & SET BACK  
PERRY TOWNSHIP ZONING  
PERMIT NO. 6441  
ZONING INSPECTOR

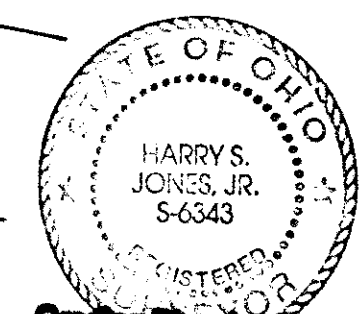

Grading Plan Approved  
as shown and noted  
THOMAS A. GRIFFIN, P.E.  
Lake County Engineer

"I, the undersigned hereby certify that this topography indicated by 6", 1' or 2' contours, and elevations shown hereon represent an actual field survey made by me on the 27th day of Jan., 1997 and that the elevations were taken at appropriate intervals and that as of that date they existed as indicated hereon."

Name Reg. No.

RIVERWOOD DRIVE - 60' from